



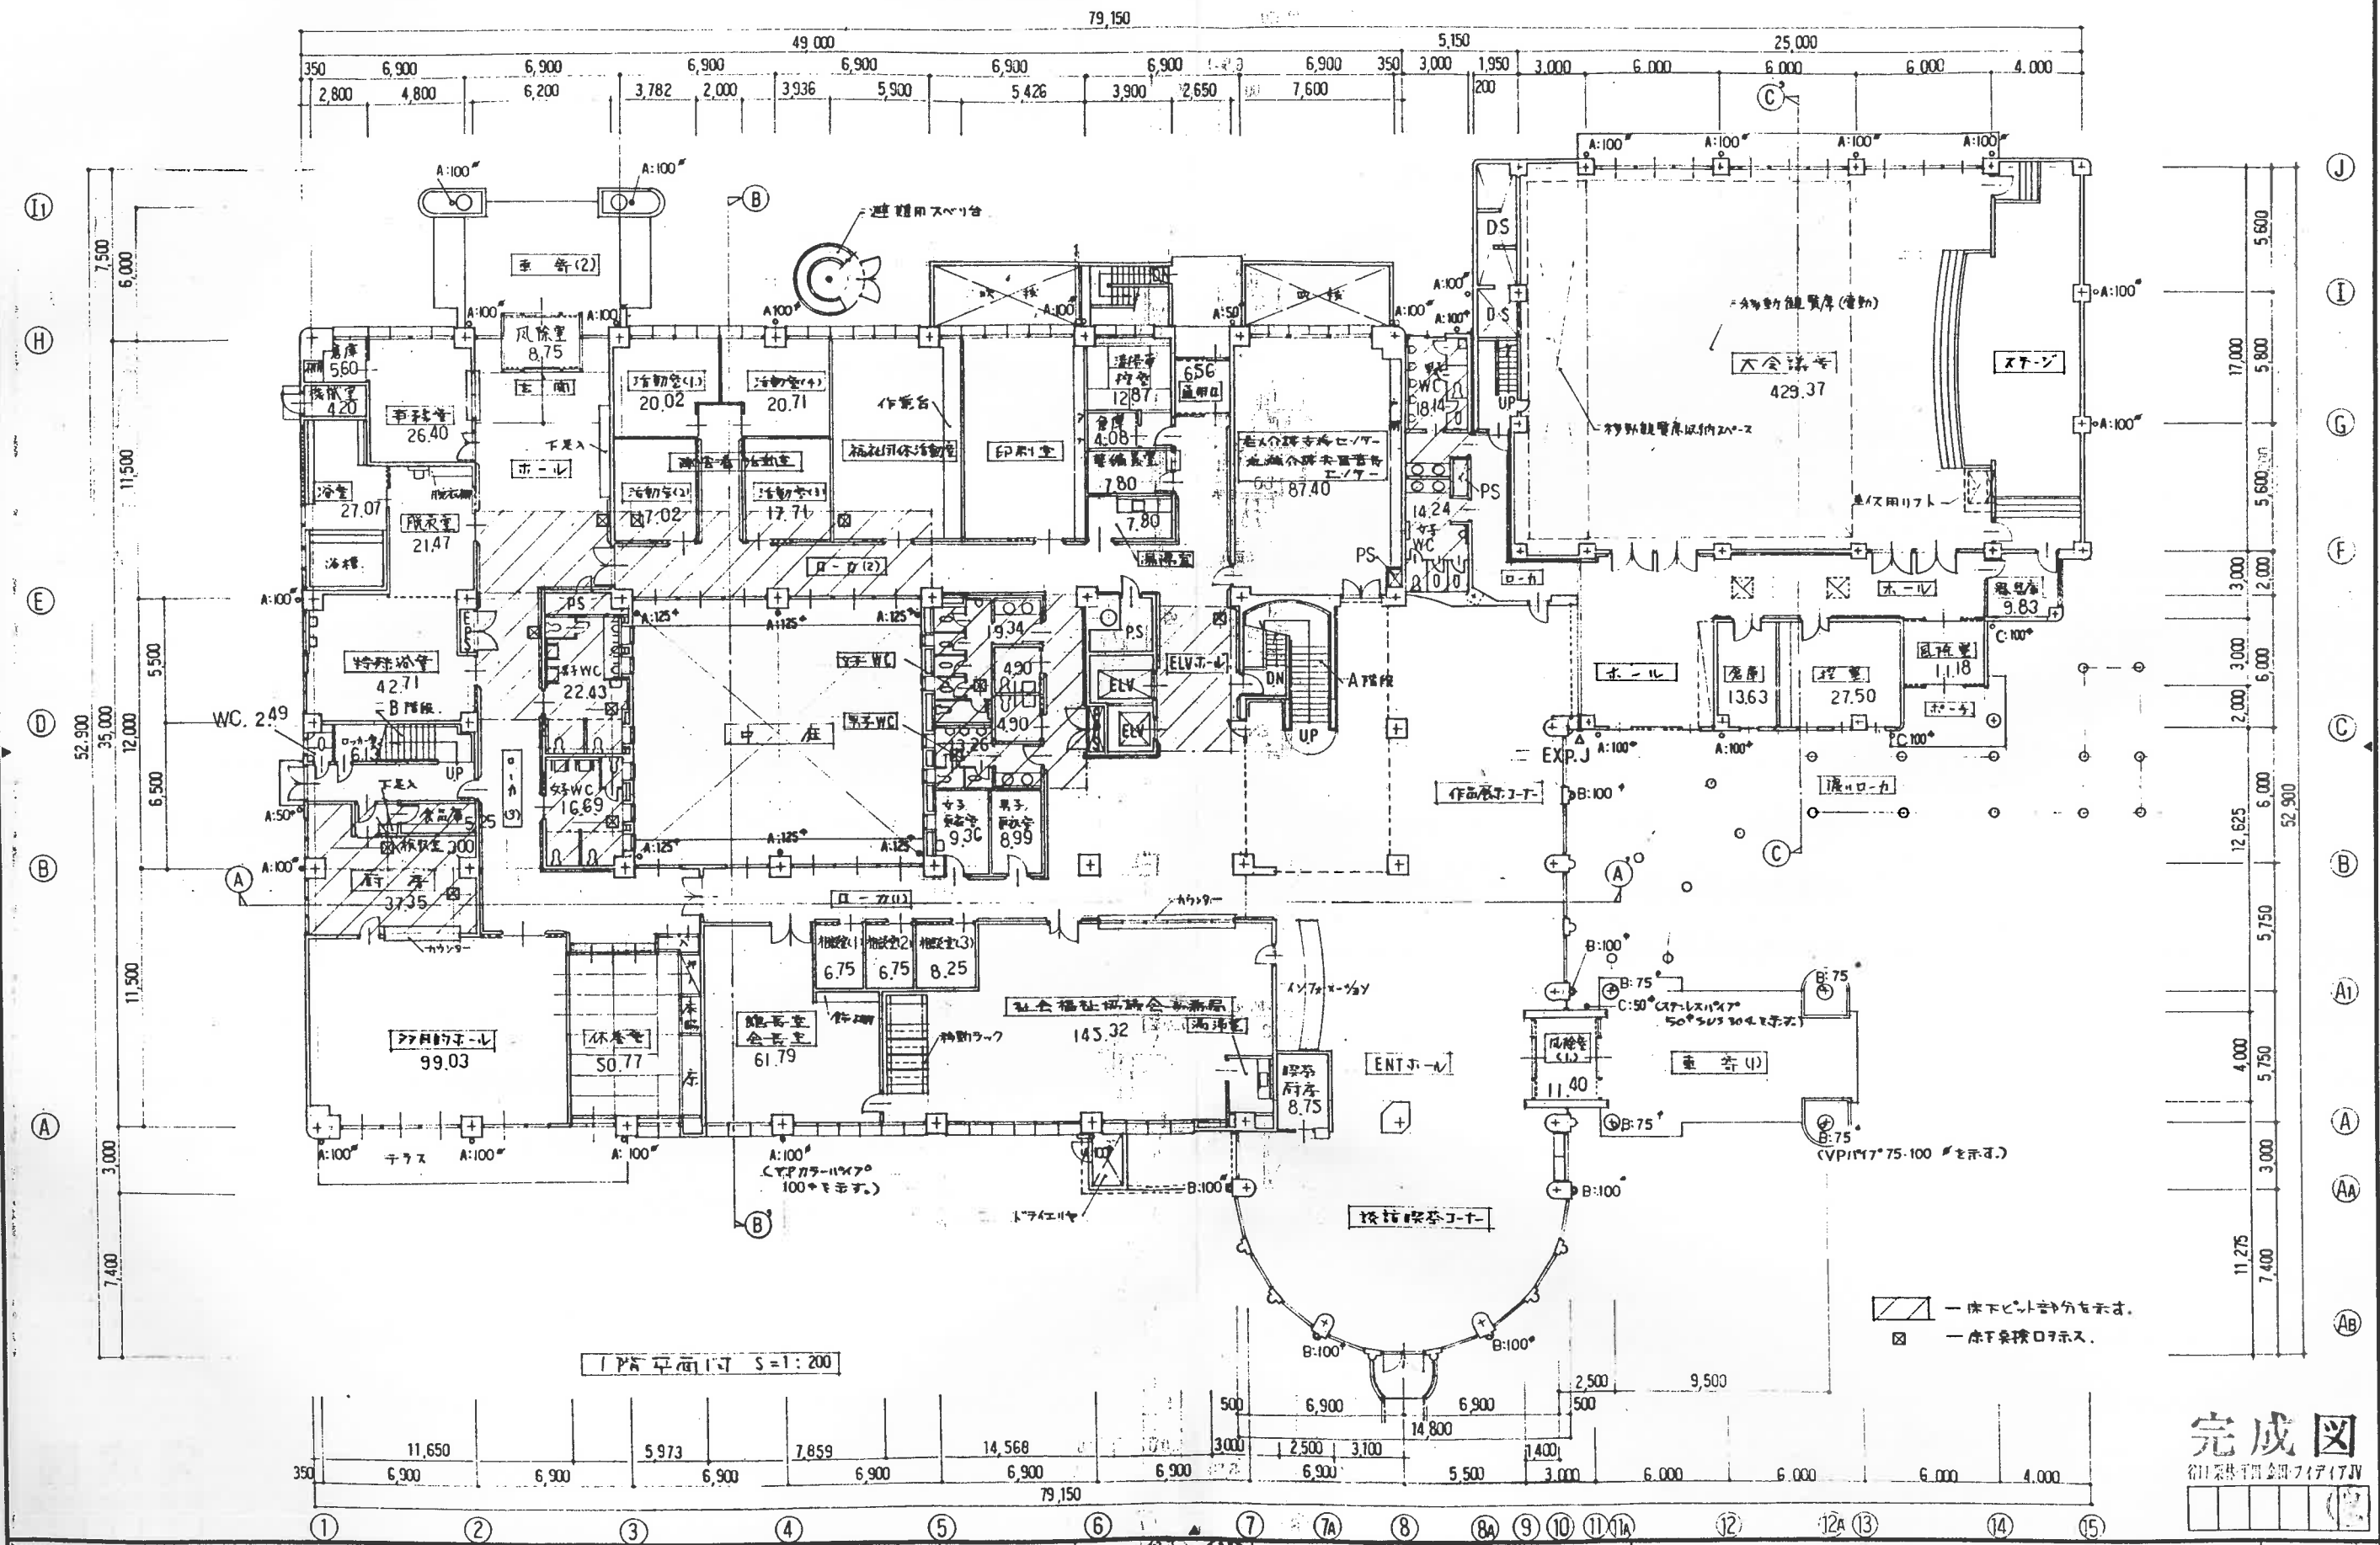


TITLE	NAME	SCALE	DATE	CHECK	DRAWING	NO
米子市福祉保健総合センター新築工事	1F 平面図	1:200	H 7.1	内	内	26-4

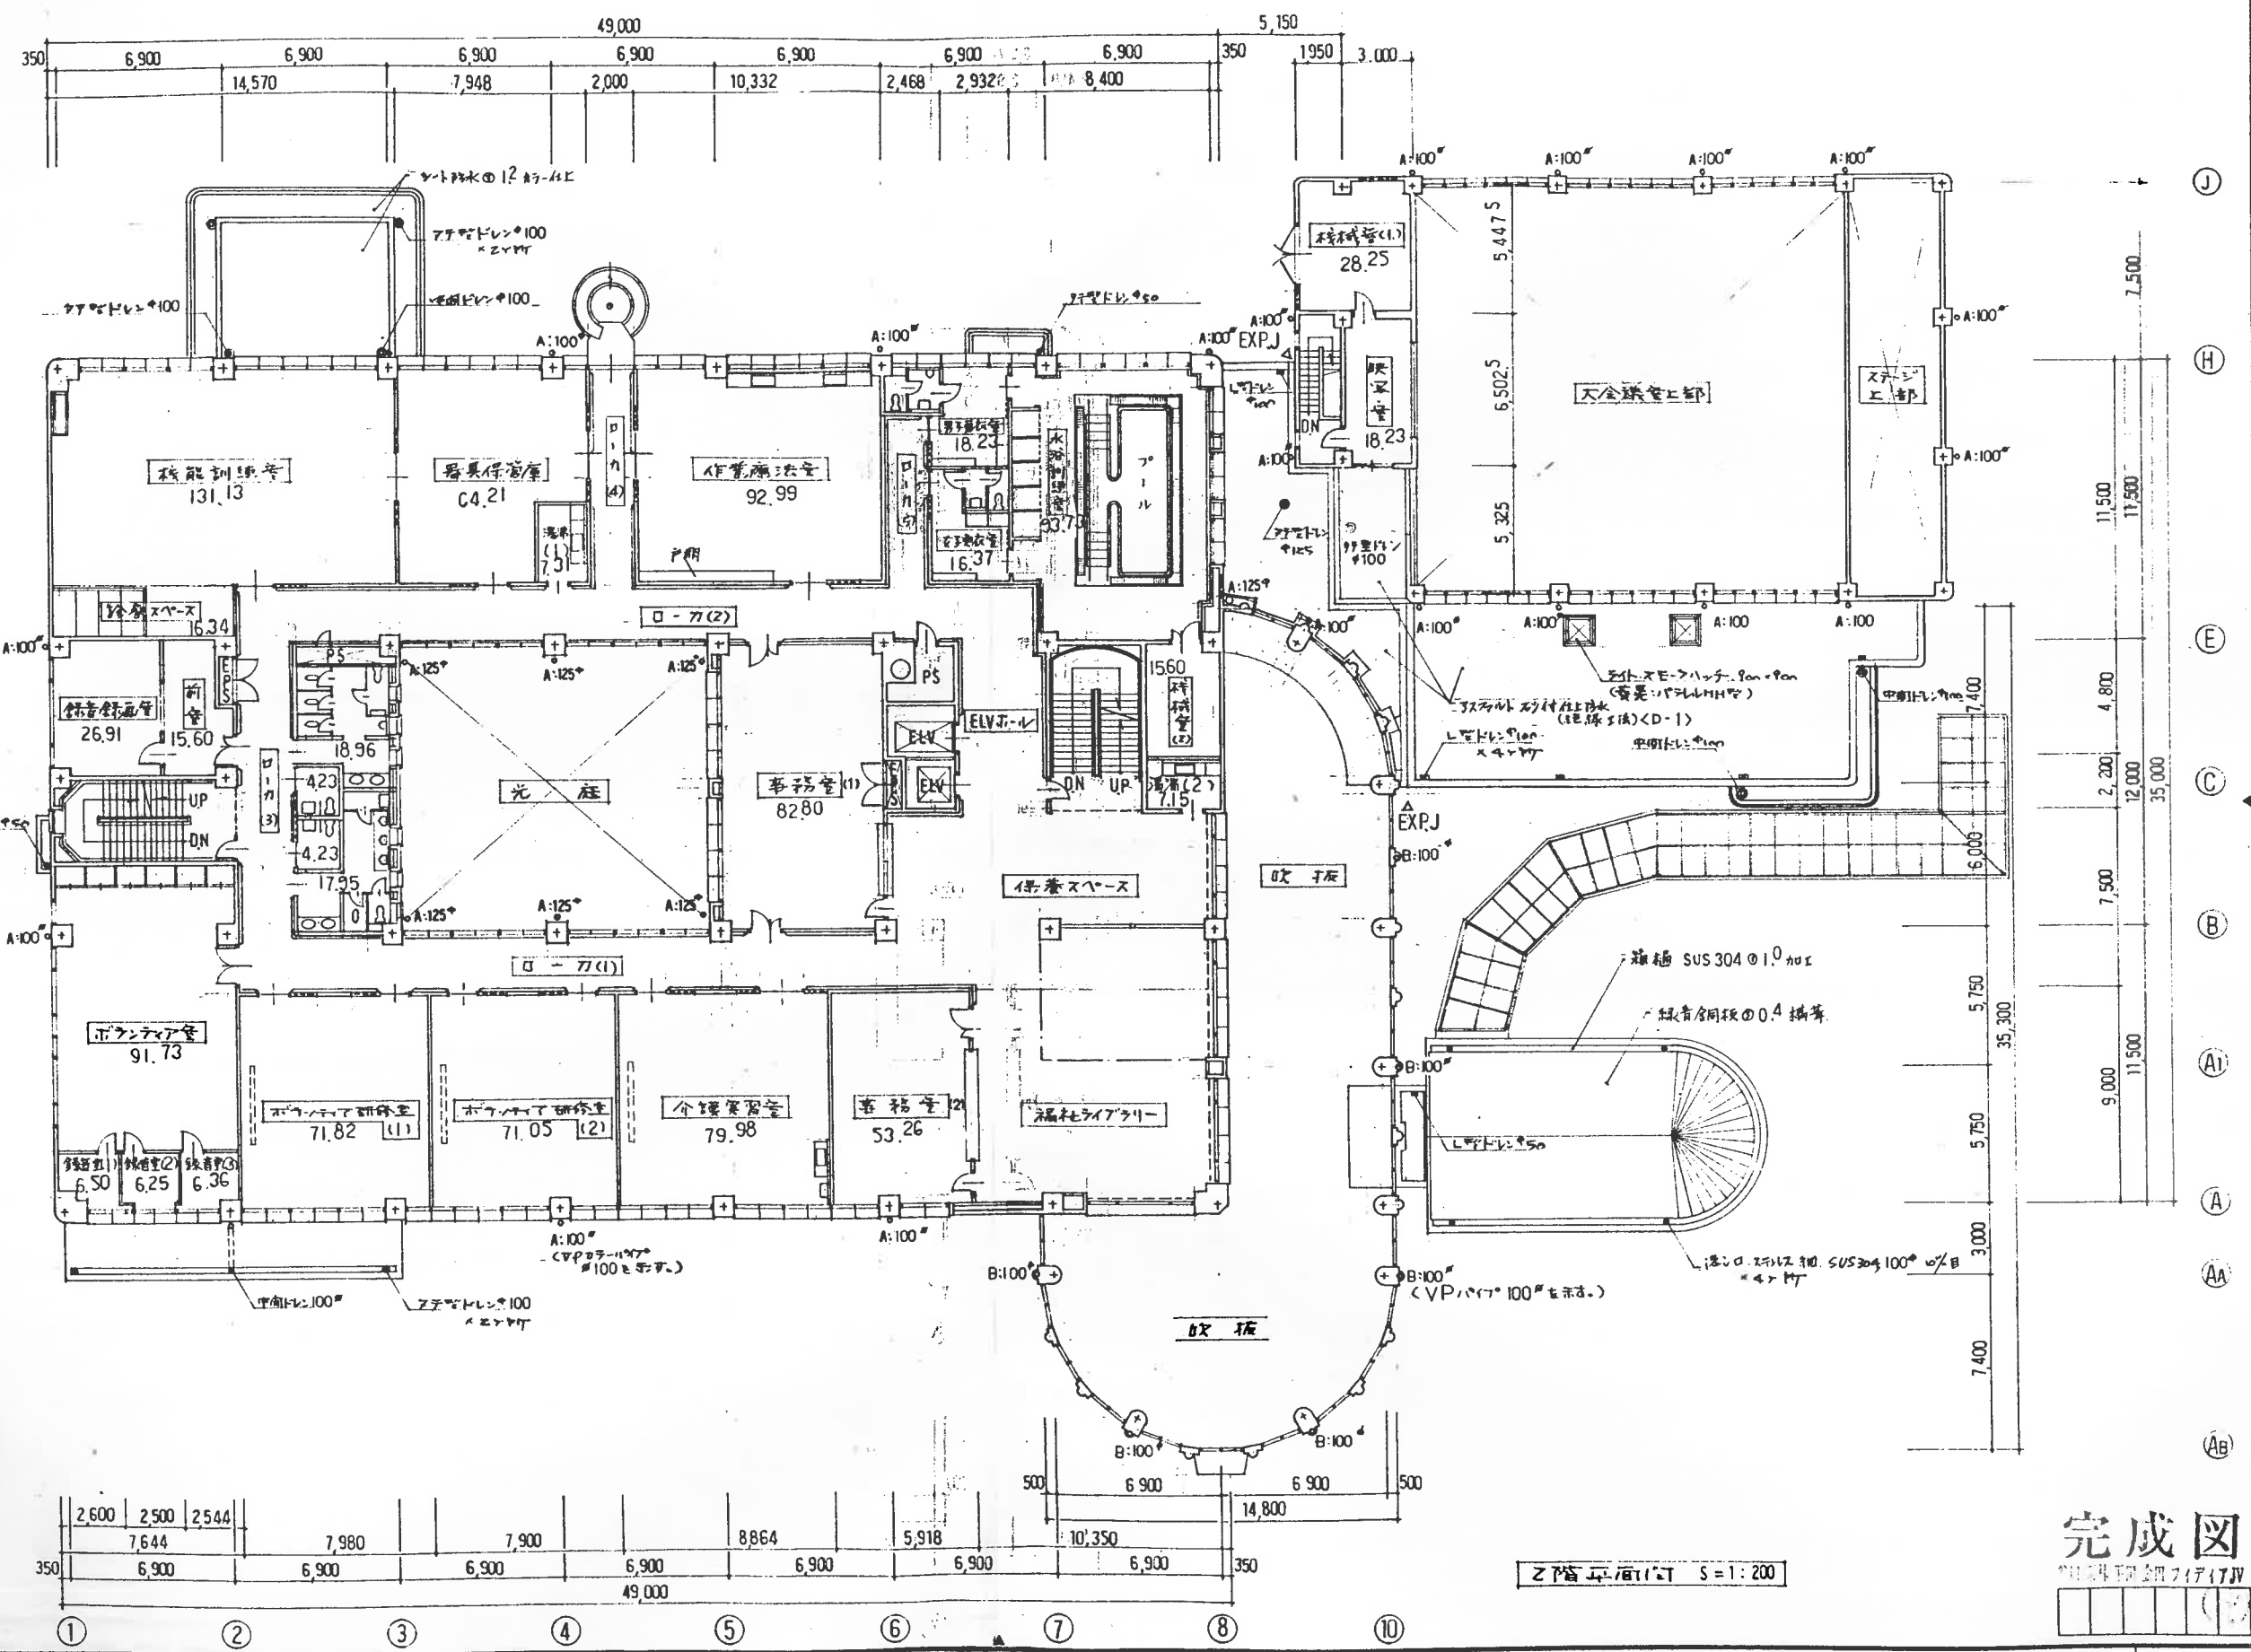

2階平面図 S=1:200

完成図
2024.07.17

TITLE	NAME	SCALE	DATE	CHECK	DRAWING	NO
米子市福祉保健総合センター新築工事	2階平面図	1:200	H 7.1			26-5
株式会社 桑本建築設計事務所						NO
一級建築士事務所 登録5-355号 一級建築士登録42737号 高田 滋之助						

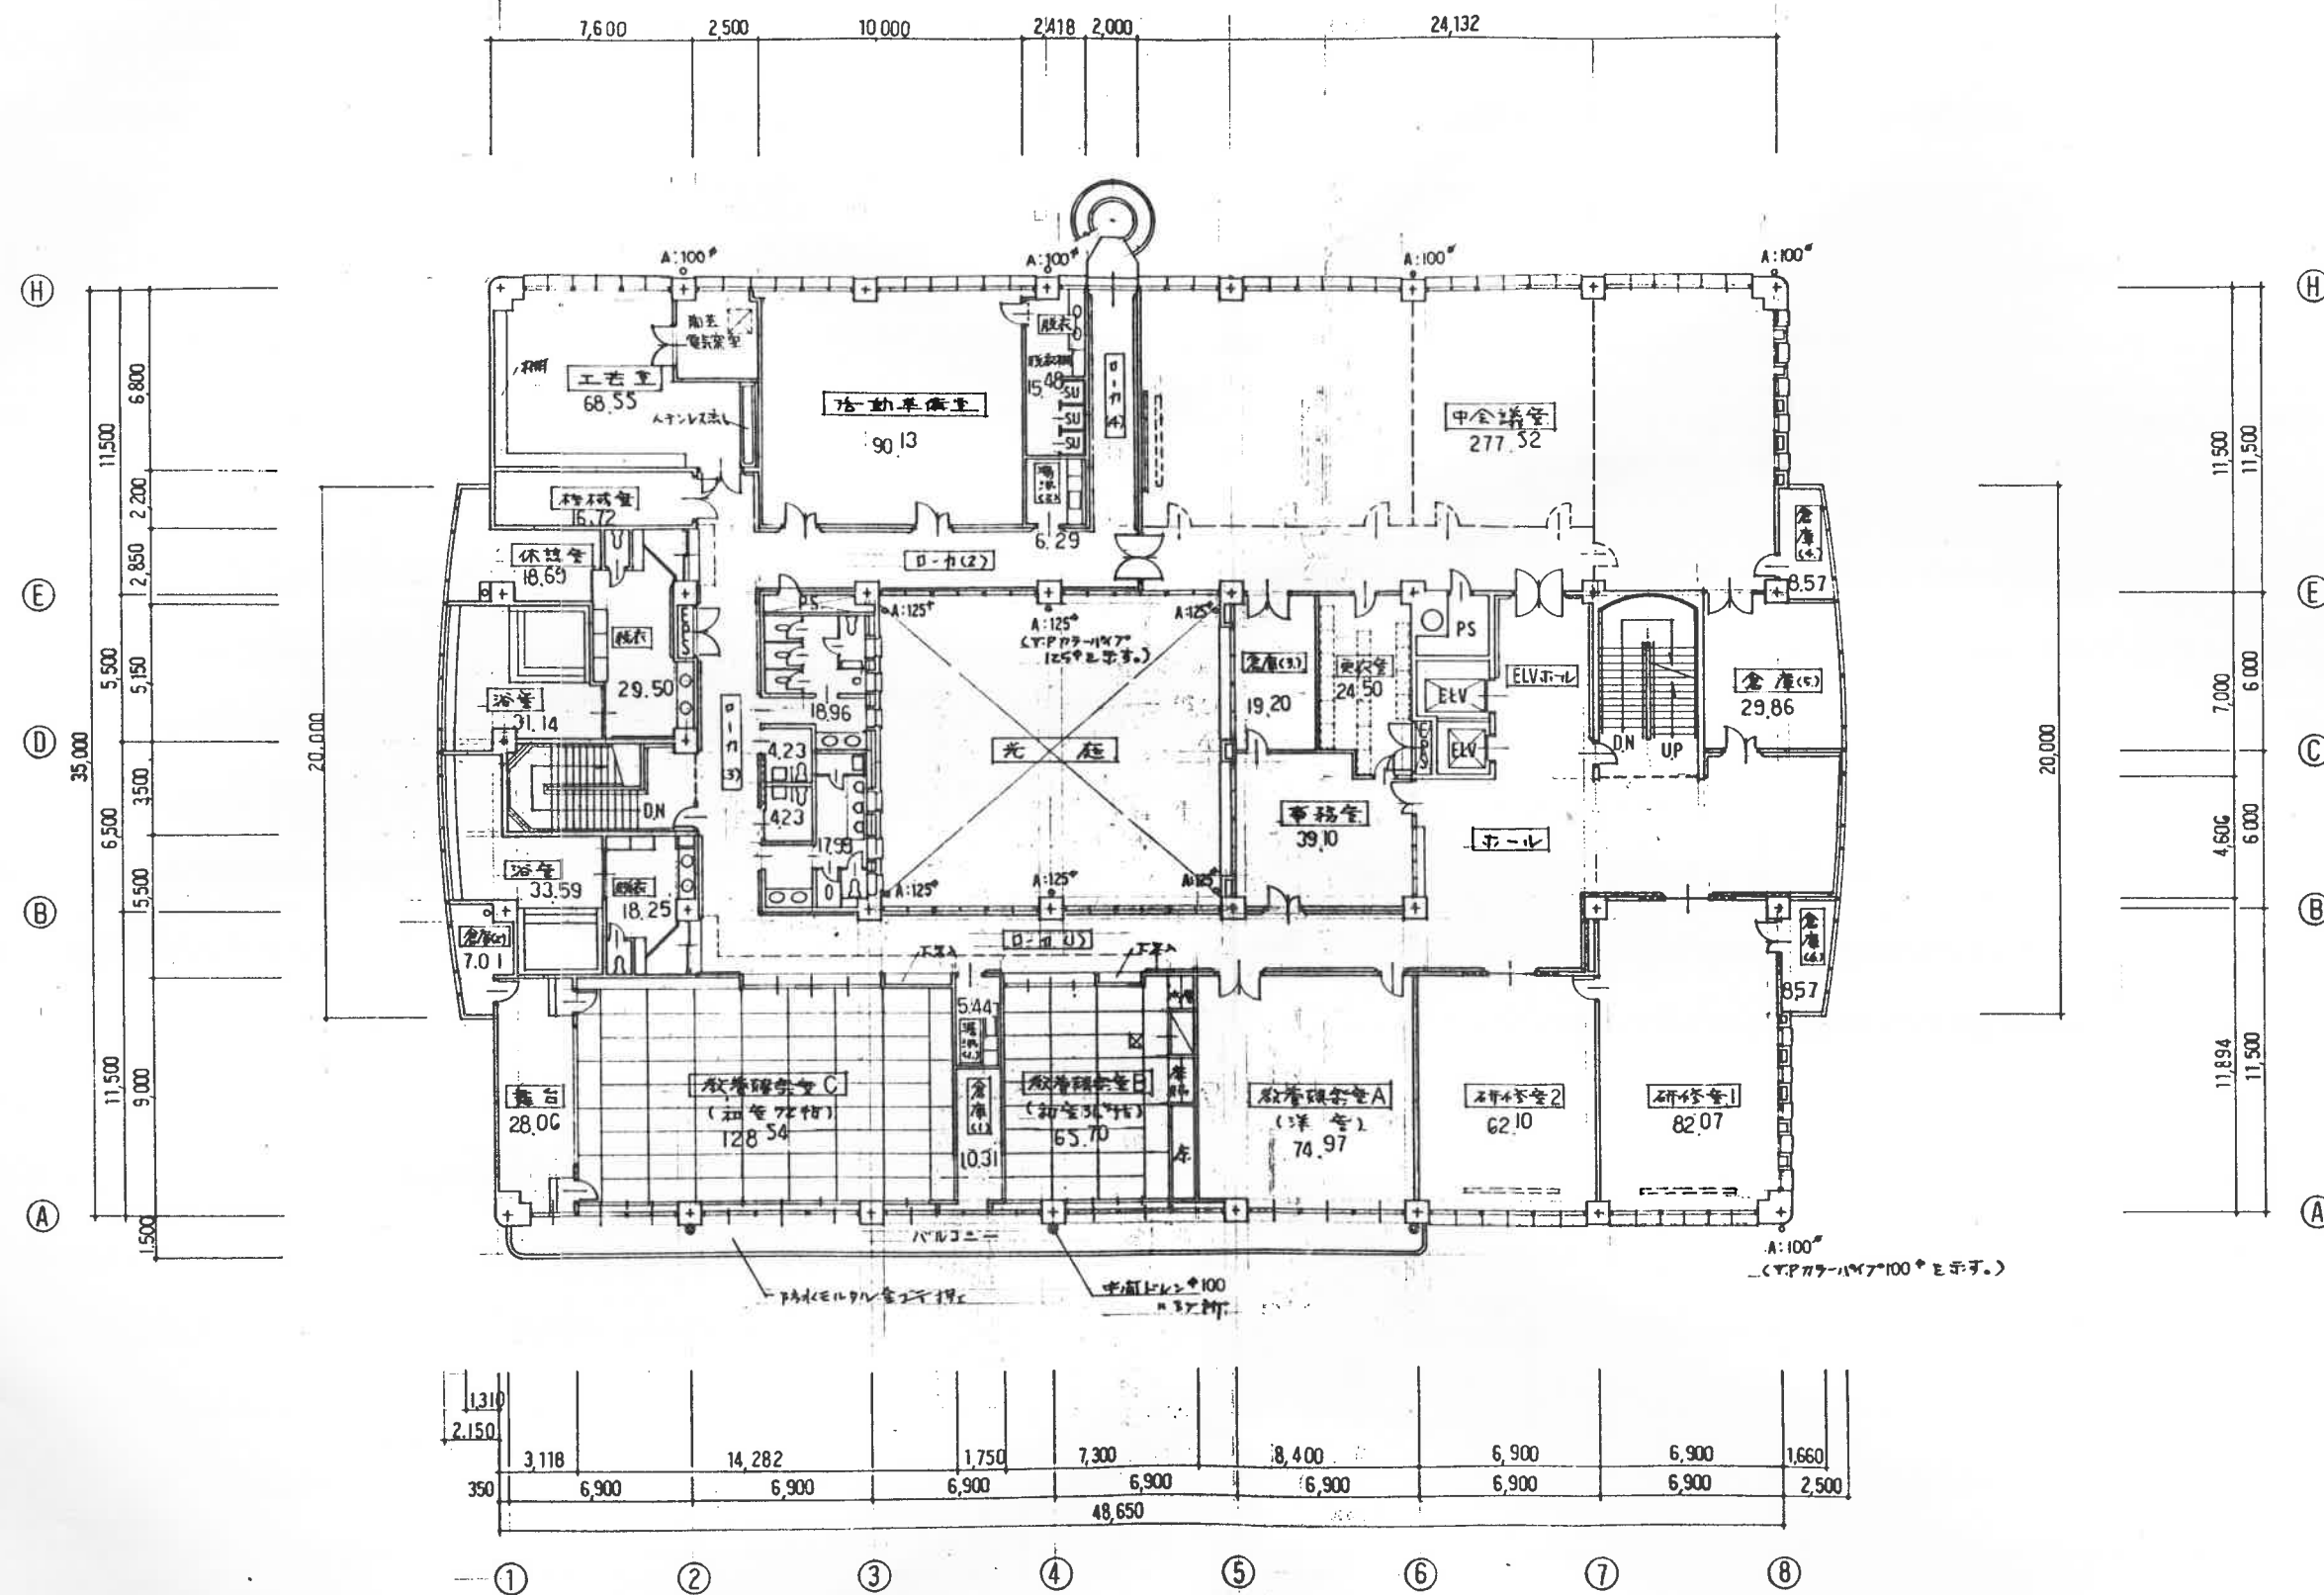

4階平面図, S=1:200


完成図

外口 米子市福祉保健総合センター新築工事


NO. 26-7

TITLE	NAME	SCALE	DATE	CHECK	DRAWING	株式会社 桑本建築設計事務所	NO
米子市福祉保健総合センター新築工事	4階平面図	1:200	H 7.1	(印)	(印)	一級建築士事務所 登録5-355号 一級建築士登録42737号 高田 滋之助	26-7

1F

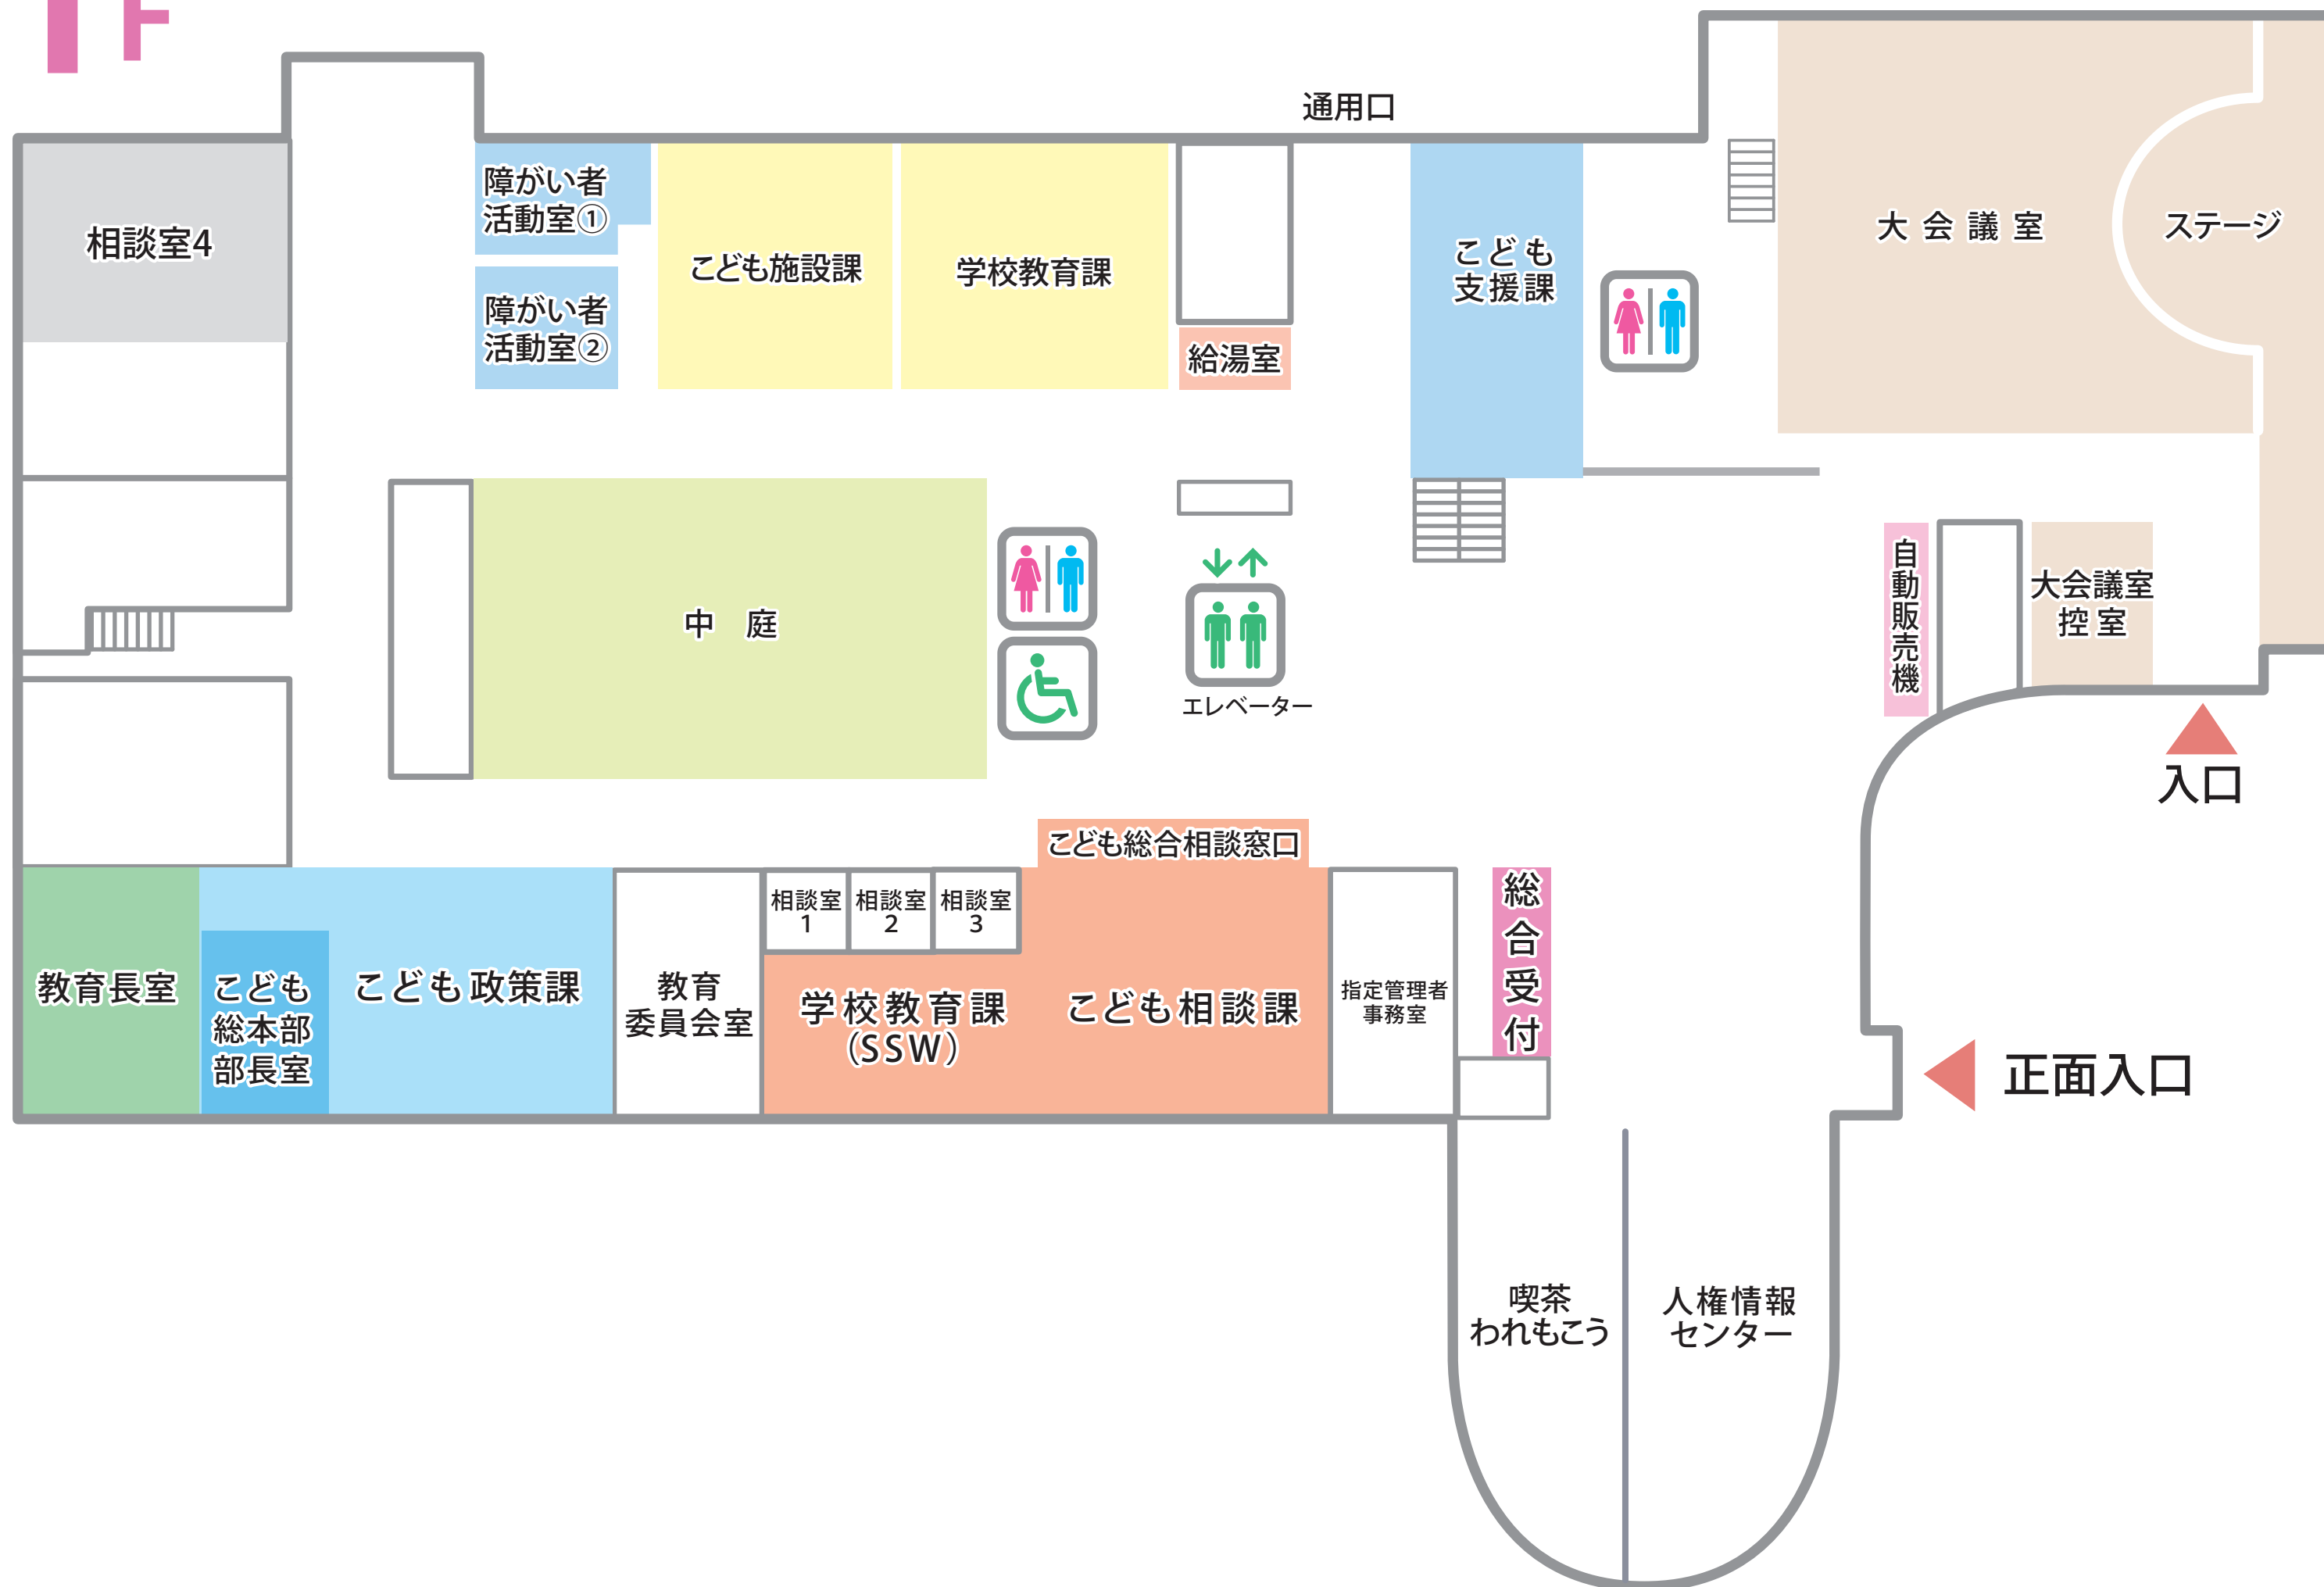

2階

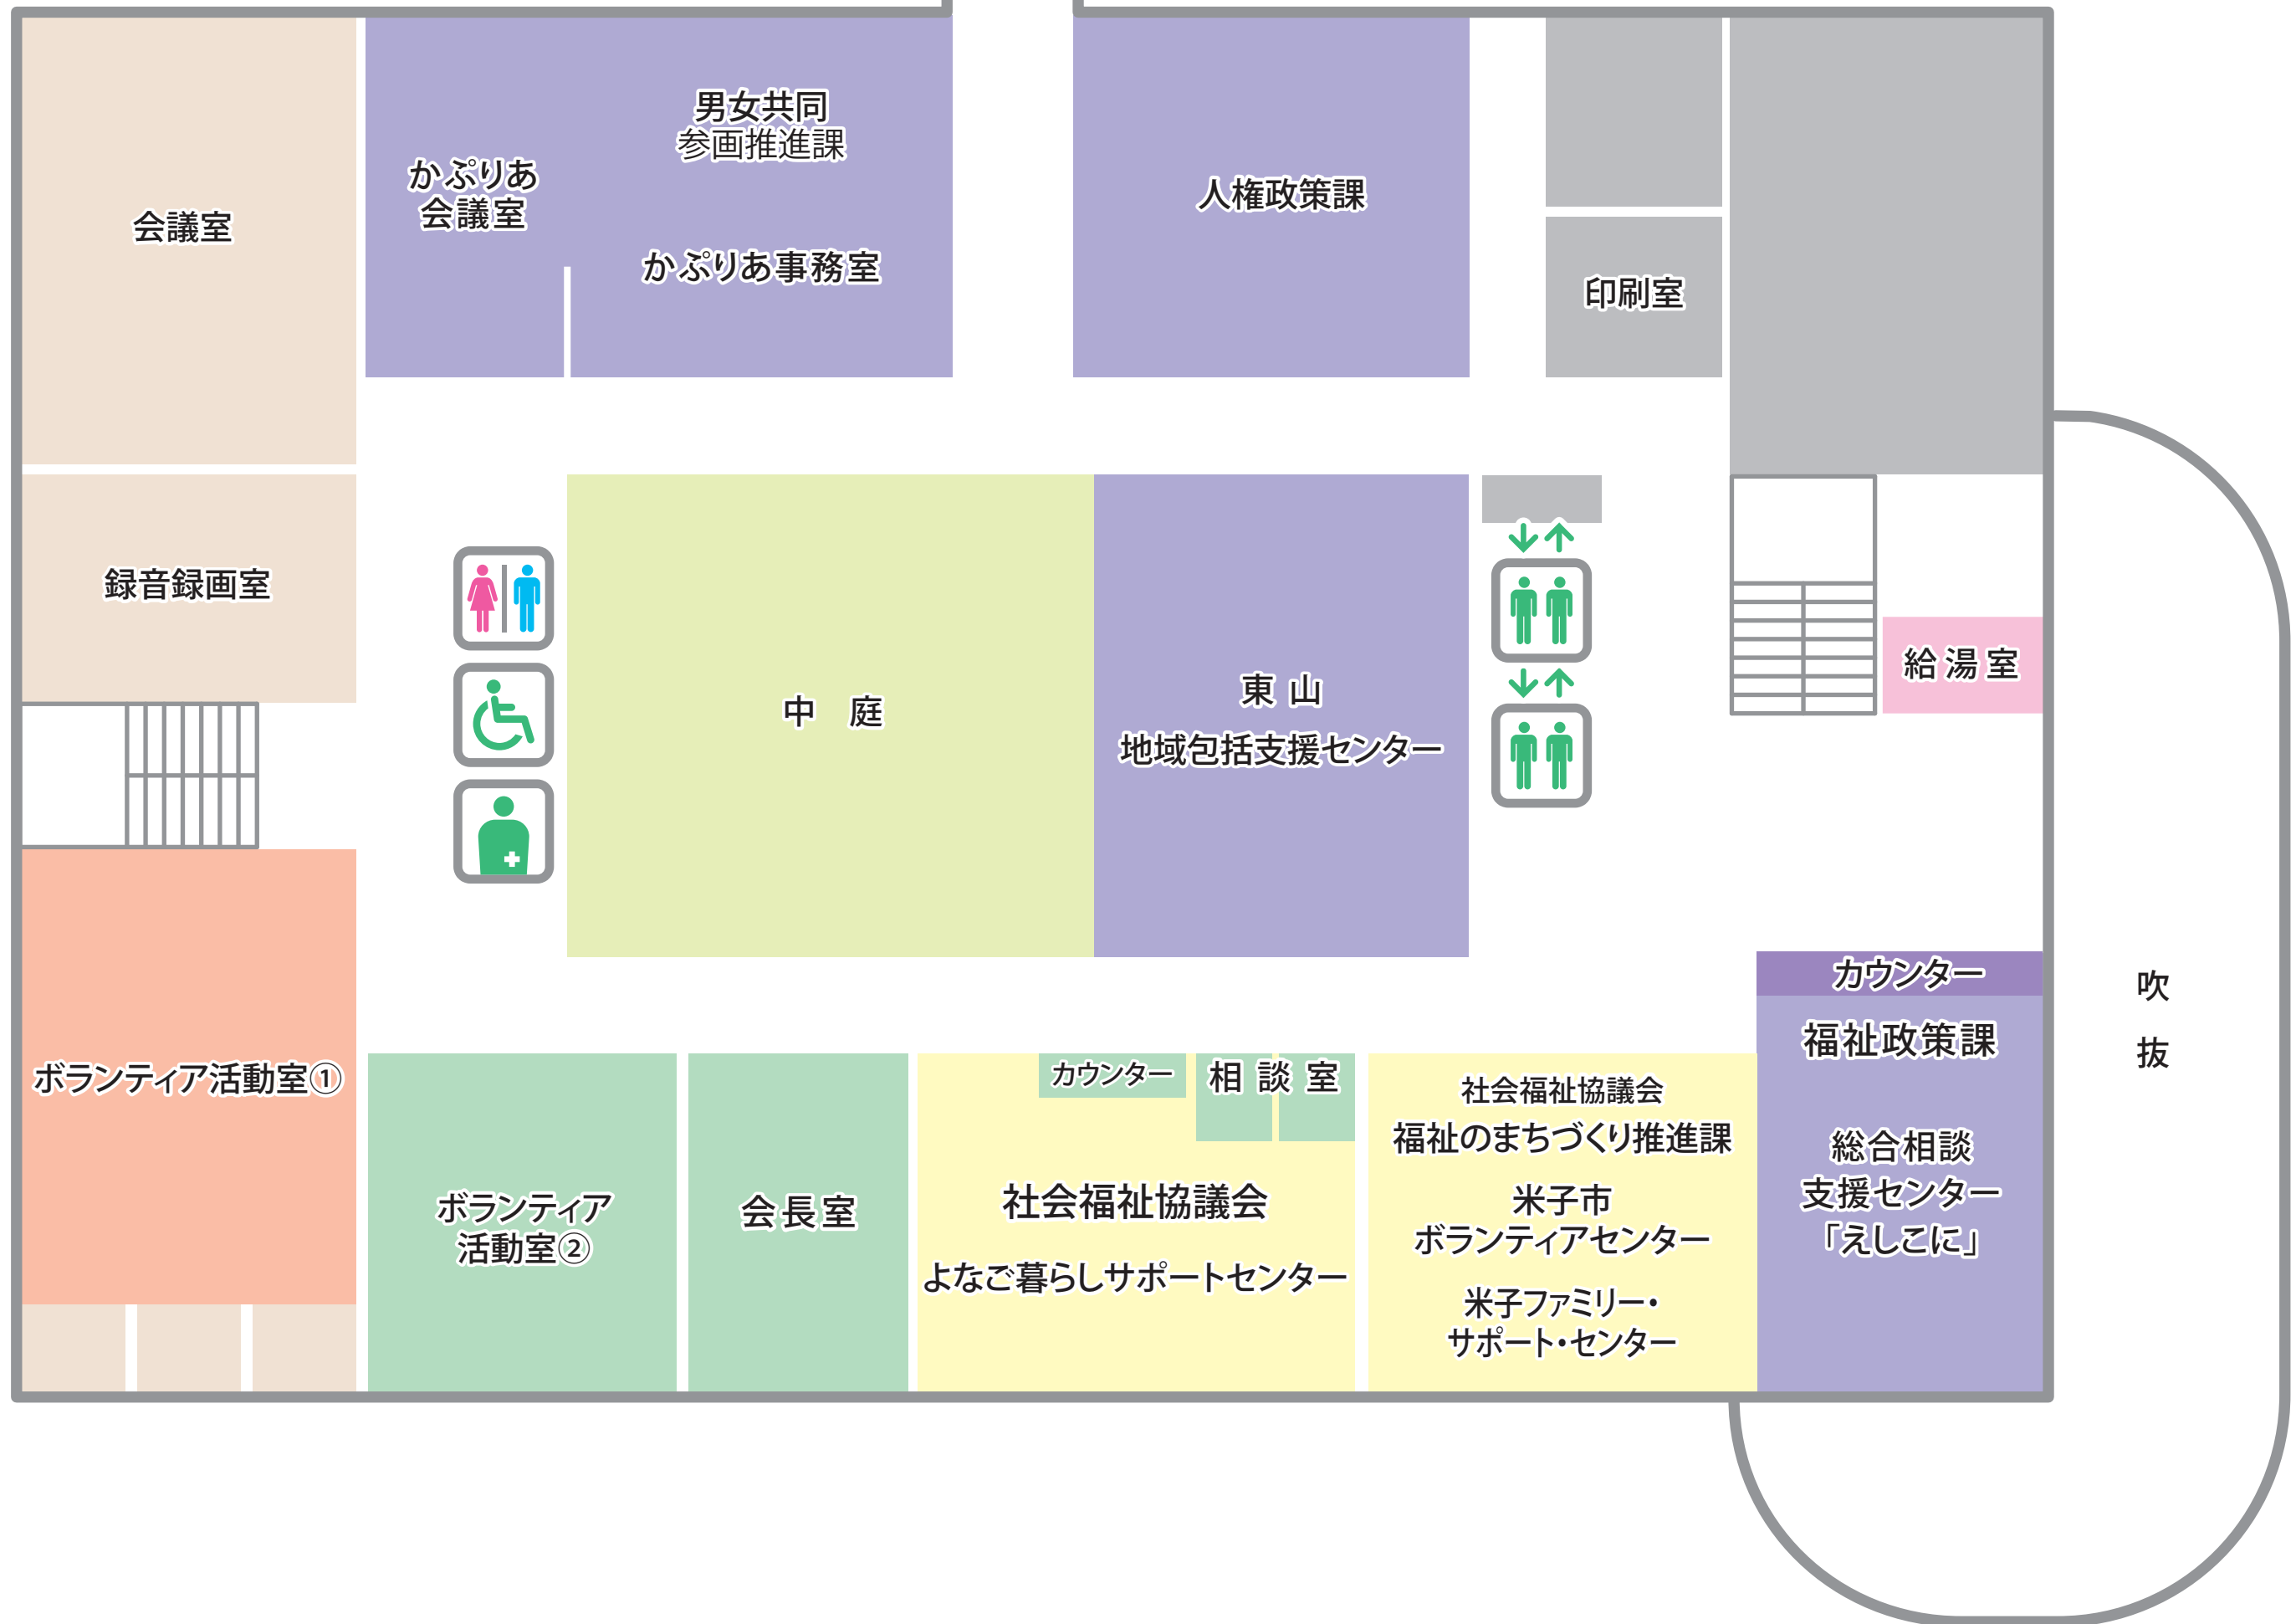

The floor plan of the Health Center (健康センター) includes the following rooms and facilities:

- 栄養指導室** (Nutrition Guidance Room)
- 栄養相談室** (Nutrition Consultation Room)
- プレイルーム** (Play Room)
- 保健指導室** (Health Guidance Room)
- 診療室** (Clinic Room) with three numbered rooms (①, ②, ③)
- 歯科指導室** (Dental Guidance Room)
- 和室** (Japanese Room)
- 湯沸室** (Water Heating Room)
- 中庭** (Central Courtyard)
- ホール** (Hall)
- 運動指導室** (Exercise Guidance Room)
- 相談室** (Consultation Room) with two numbered rooms (①, ②)
- 保健センター事務室** (Health Center Office)
- 健康対策課** (Health Countermeasure Section)
- フレイル対策推進課** (Frailty Countermeasure Promotion Section)

Accessibility features include a wheelchair icon, a first aid icon, and a family icon near the central courtyard.

4F

